

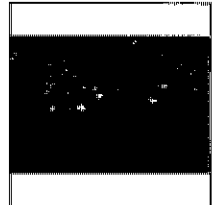


FLOOR 01

128-130 YORK STREET, OTTAWA, ON
(AS-BUILT FLOOR PLAN)

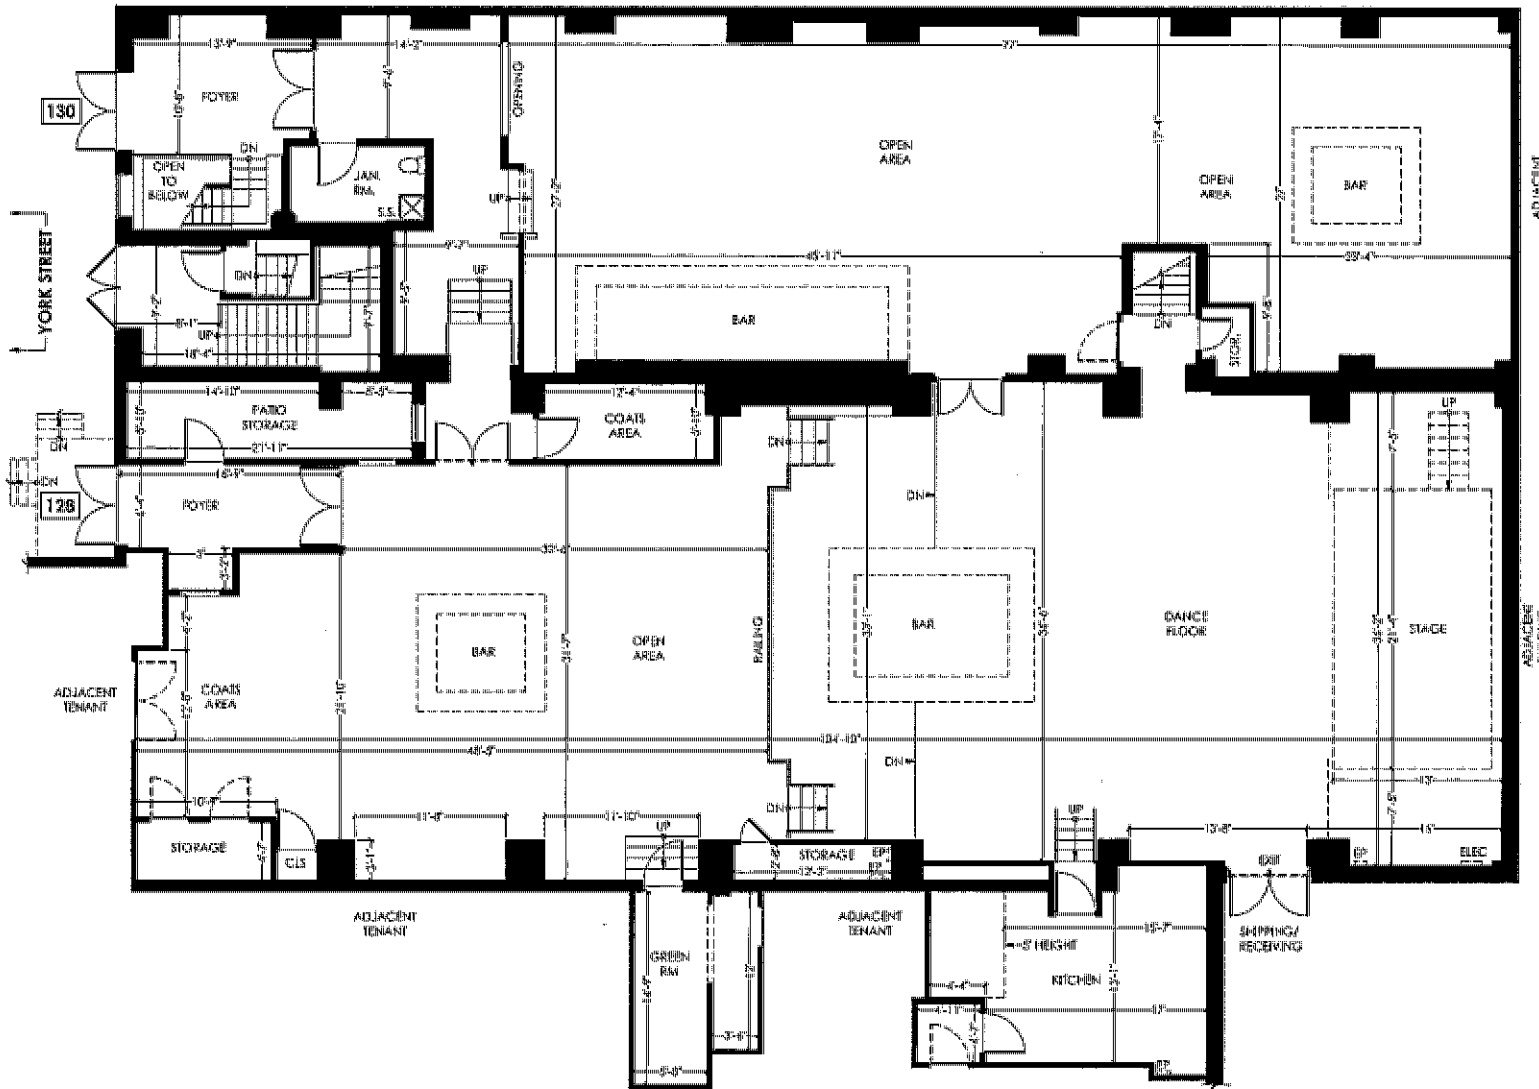

AERIAL VIEW

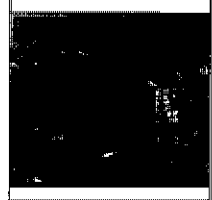

EXTERIOR VIEW

- LEGEND:
- EXISTING WALLS
 - ELEC ELECTRICAL PANEL
 - EP ELECTRICAL PANEL
 - HW HOT WATER TANK
 - T TRANSFORMER
 - TEL TELECOMMUNICATIONS

PREPARED FOR: District Realty,
Construction Management
ADDRESS: 128-130 York St., Ottawa, ON
DATE: June 5, 2018
REVISION: n/a
PROJECT NUMBER: 2002.F3
DRAWING SCALE: 1/8" = 1' - 0" Tabloid Size



NOTE: SOME AREAS WERE NOT ACCESSIBLE TO MEASUREMENT

PREPARED BY: ECHOGROUP.COM